

18,601

FILED FOR RECORD
at 1:30 o'clock P M

JAN 23 2024

BECKY LANDRUM
County Clerk, Hunt County, Tex.

By Jason Conover

Oncor Electric Delivery
Jason Conover
Associate Designer
3873 Hwy 68N
Greenville, TX 75401



January 8, 2024

Office of County Commissioners
PO Box 1097 Greenville, TX 75403

RE: Overhead Distribution Line Installation CR 1033 WO 21626864


Greetings,

Oncor Electric Delivery LLC., is requesting permission to do work within the county right of way along County Road 1033 west of the intersection of County Road 1032 and County Road 1033. We are looking to install a single phase OH distribution line approximately 5' inside the South ROW of County Road 1033. Site location map and permit exhibit are enclosed. The permit exhibit details the proposed work. If you have any questions, please contact at any time.

Sincerely,

A handwritten signature in black ink that reads "Jason Conover". The signature is written in a cursive, flowing style.

Jason Conover
Associate Designer

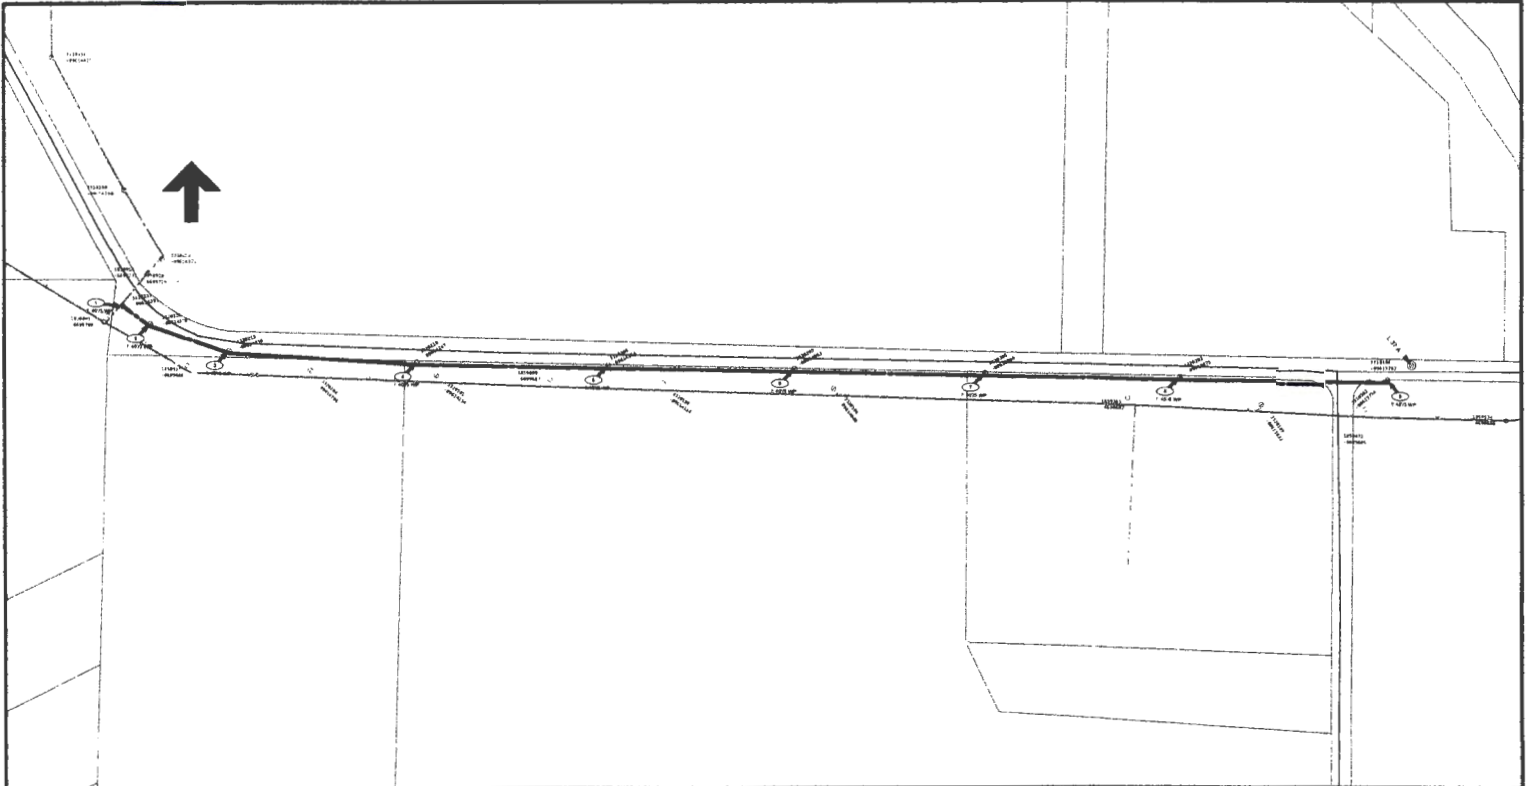

ELECTRIC CONSTRUCTION PRINT

WO Number: **21626864-01** Date: 2023/12/14 Description: **TEX SUL CLSTE2101 Oncor replace deteriorated fac to reenergize line**

Sheet: **4** of Scale: 1"=50' Customer:

Job Status: **AsBuilt** Svc Ctr / Office: / Address: **CR 1033, GREENVILLE, HUNT 75401,**

Designer: **CONOVER, STEVEN J/UBXX** 903-458-0725 Location:

Project Mgr: /

Copyright 2018 Oncor Electric Delivery. Maps, drawings, and electronic data (products) are created for the internal purposes of Oncor Electric Delivery with no implication of suitability or fitness for the intended use of the recipient. Oncor Electric Delivery will make good faith efforts to provide products that are free from error, but does not warrant the accuracy or quality of such products. The locations shown are approximations and are not intended to show exact locations. Products provided to other parties by Oncor Electric Delivery are for the internal use of the recipient, and the recipient agrees not to duplicate or distribute the products or any portion of the products to third parties without the prior written permission of Oncor Electric Delivery. The recipient further agrees to hold harmless and indemnify Oncor Electric Delivery against all claims, costs, expenses and damages resulting from or predicated upon strict liability for personal injury, death or or property damage, or loss of use of any property provided hereunder.